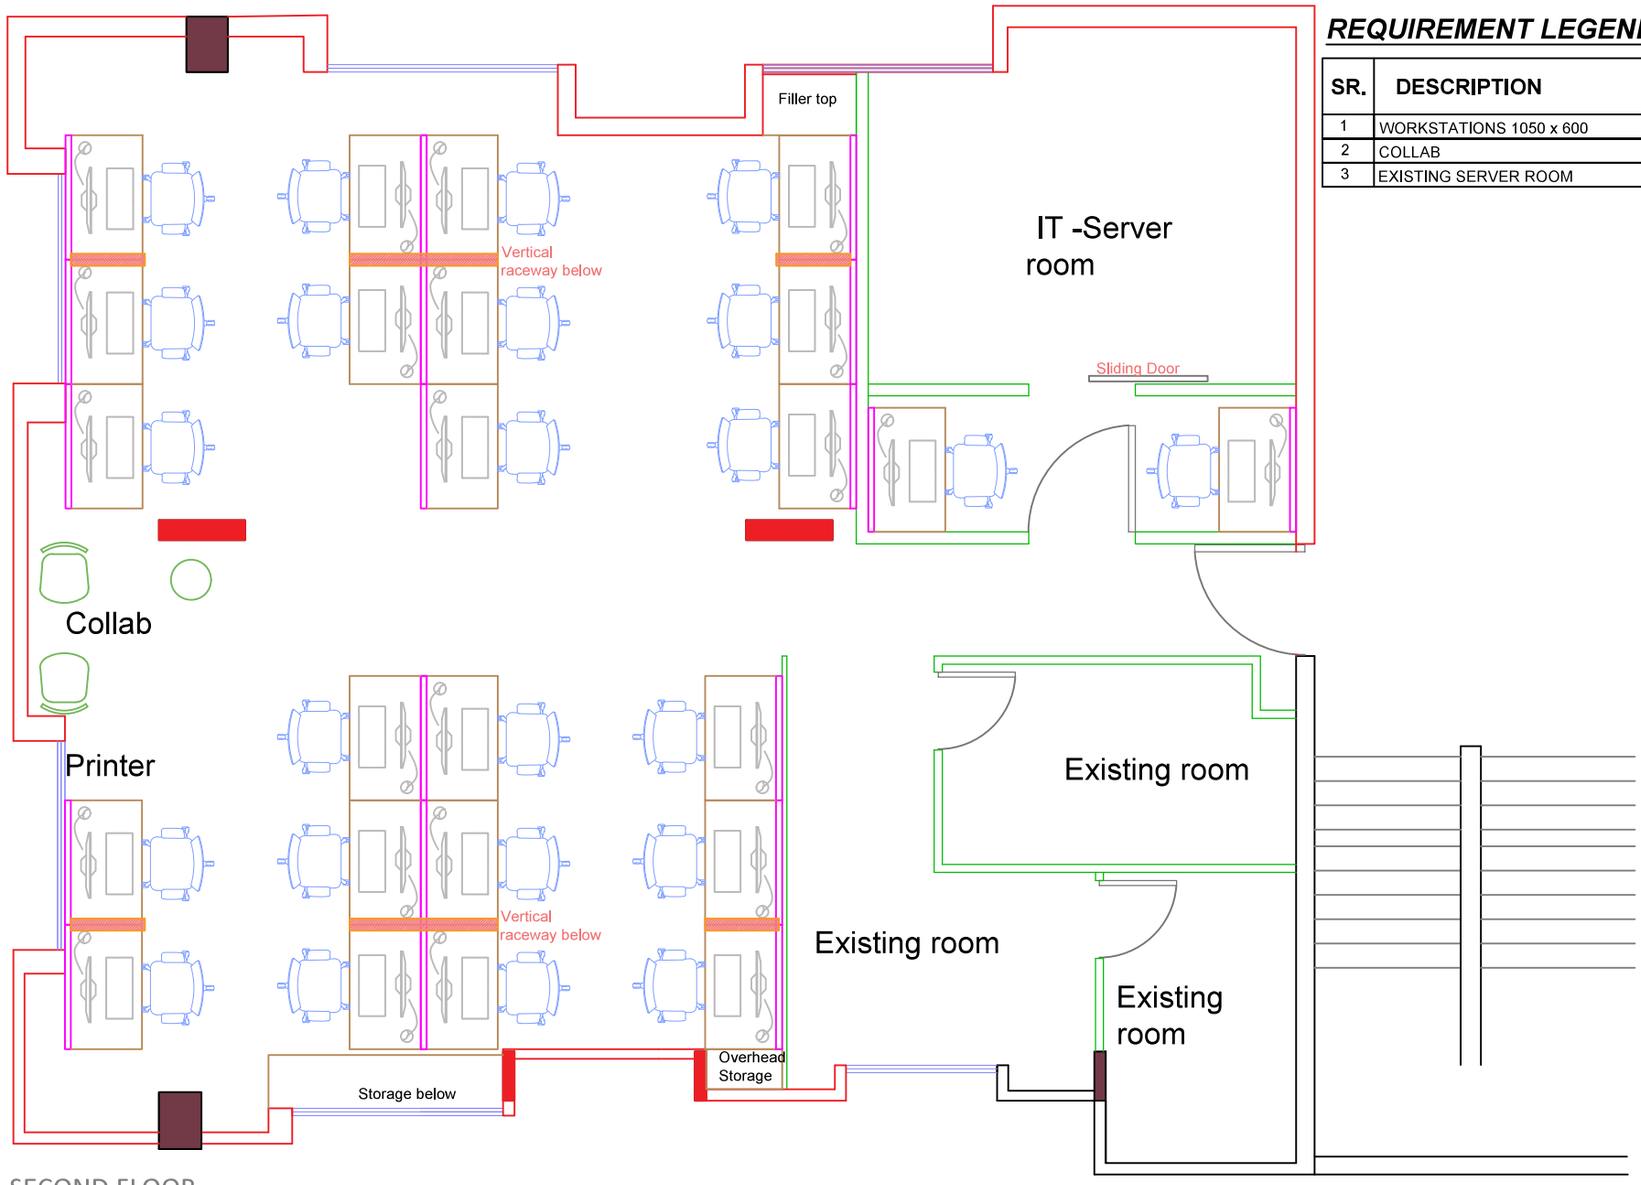


REQUIREMENT LEGEND

SR.	DESCRIPTION	REQUIRED N0.	PROPOSED N0.
1	WORKSTATIONS 1050 x 600	20 NO.	22 NO.
2	COLLAB	01 NO.	01 NO.
3	EXISTING SERVER ROOM	01 NO.	01 NO.

SECOND FLOOR

NOTE:-

1. All information contained in this document are confidential and copyright of LEELA ASSOCIATES. Any information in this sheet shall not be used for any purpose other than for which they are intended and supplied and shall not be copied or reproduced in any form without written permission of LEELA ASSOCIATES .
2. This is not a stand-alone document. This drawing must be read in conjunction with all other drawings, technical specifications, details/documents, BOQs and material boards.
3. All dimensions shall be verified on site prior to start of work. Any discrepancy shall be brought to the notice of the architect.
4. This drawing is to be read and is not to scale.
5. The contractor must check all dimensions and details and shall be responsible for the same. Any discrepancy shall be brought to the notice of the architect.
6. Any changes, if required, shall be confirmed by the architect and signed off, prior to the start of work.
7. Discrepancy, if any noticed by the contractor, shall be brought to the attention of the architect and be resolved within two (2) working days of issue of this drawing or prior to procurement of materials/ execution of works at site whichever is earlier .

KEY PLAN:

Rev No.	Description	Date
R1	With 1050 x 600 workstations	06.02.25
R0	With 1200 x 600 workstations	06.02.25

PROJECT ADDRESS:
6th floor, Tower B,Panchshil Business Park , Viman Nagar, Pune, Maharashtra 411014

CLIENT:
Harbinger Group

ARCHITECTS
LEELA ASSOCIATES

(C) Copyright of LEELA ASSOCIATES

AS BUILT

DRAWING TITLE:
Retrofit Interior Layout 2nd floor

Drawn by	VASANTI	Sheet No.	
Checked by	RISHI		
Designed by	VASANTI	Rev	R2
Date	29/09/2025	Scale	As indicated